



Deer Creek Golf Course

Provided by:

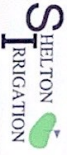

November 2017

Irrigation  
Asbuilts

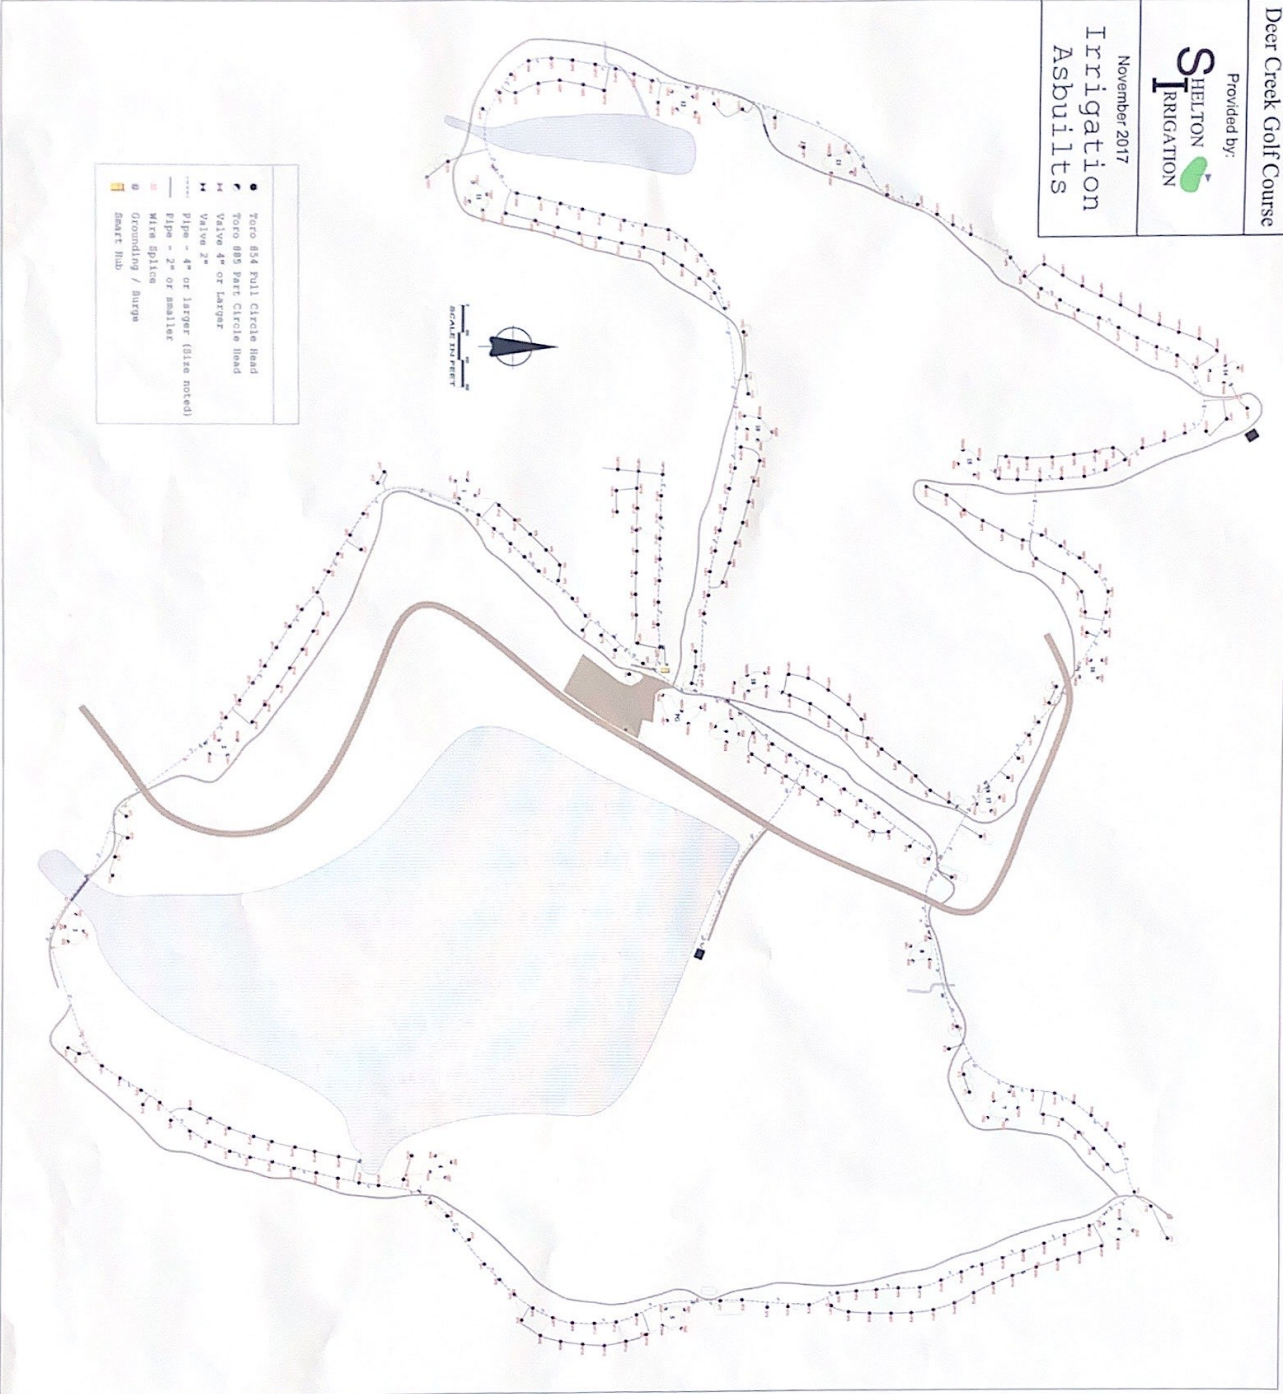

Deer Creek Golf Course

Provided by:



November 2017

Irrigation  
Asbuilts

